


DO NOT SCALE IF IN DOUBT ASK

CHOKE MANIFOLD SKID

SAFE AREA ENGINE ROOM

DRILLERS CONTROL ROOM

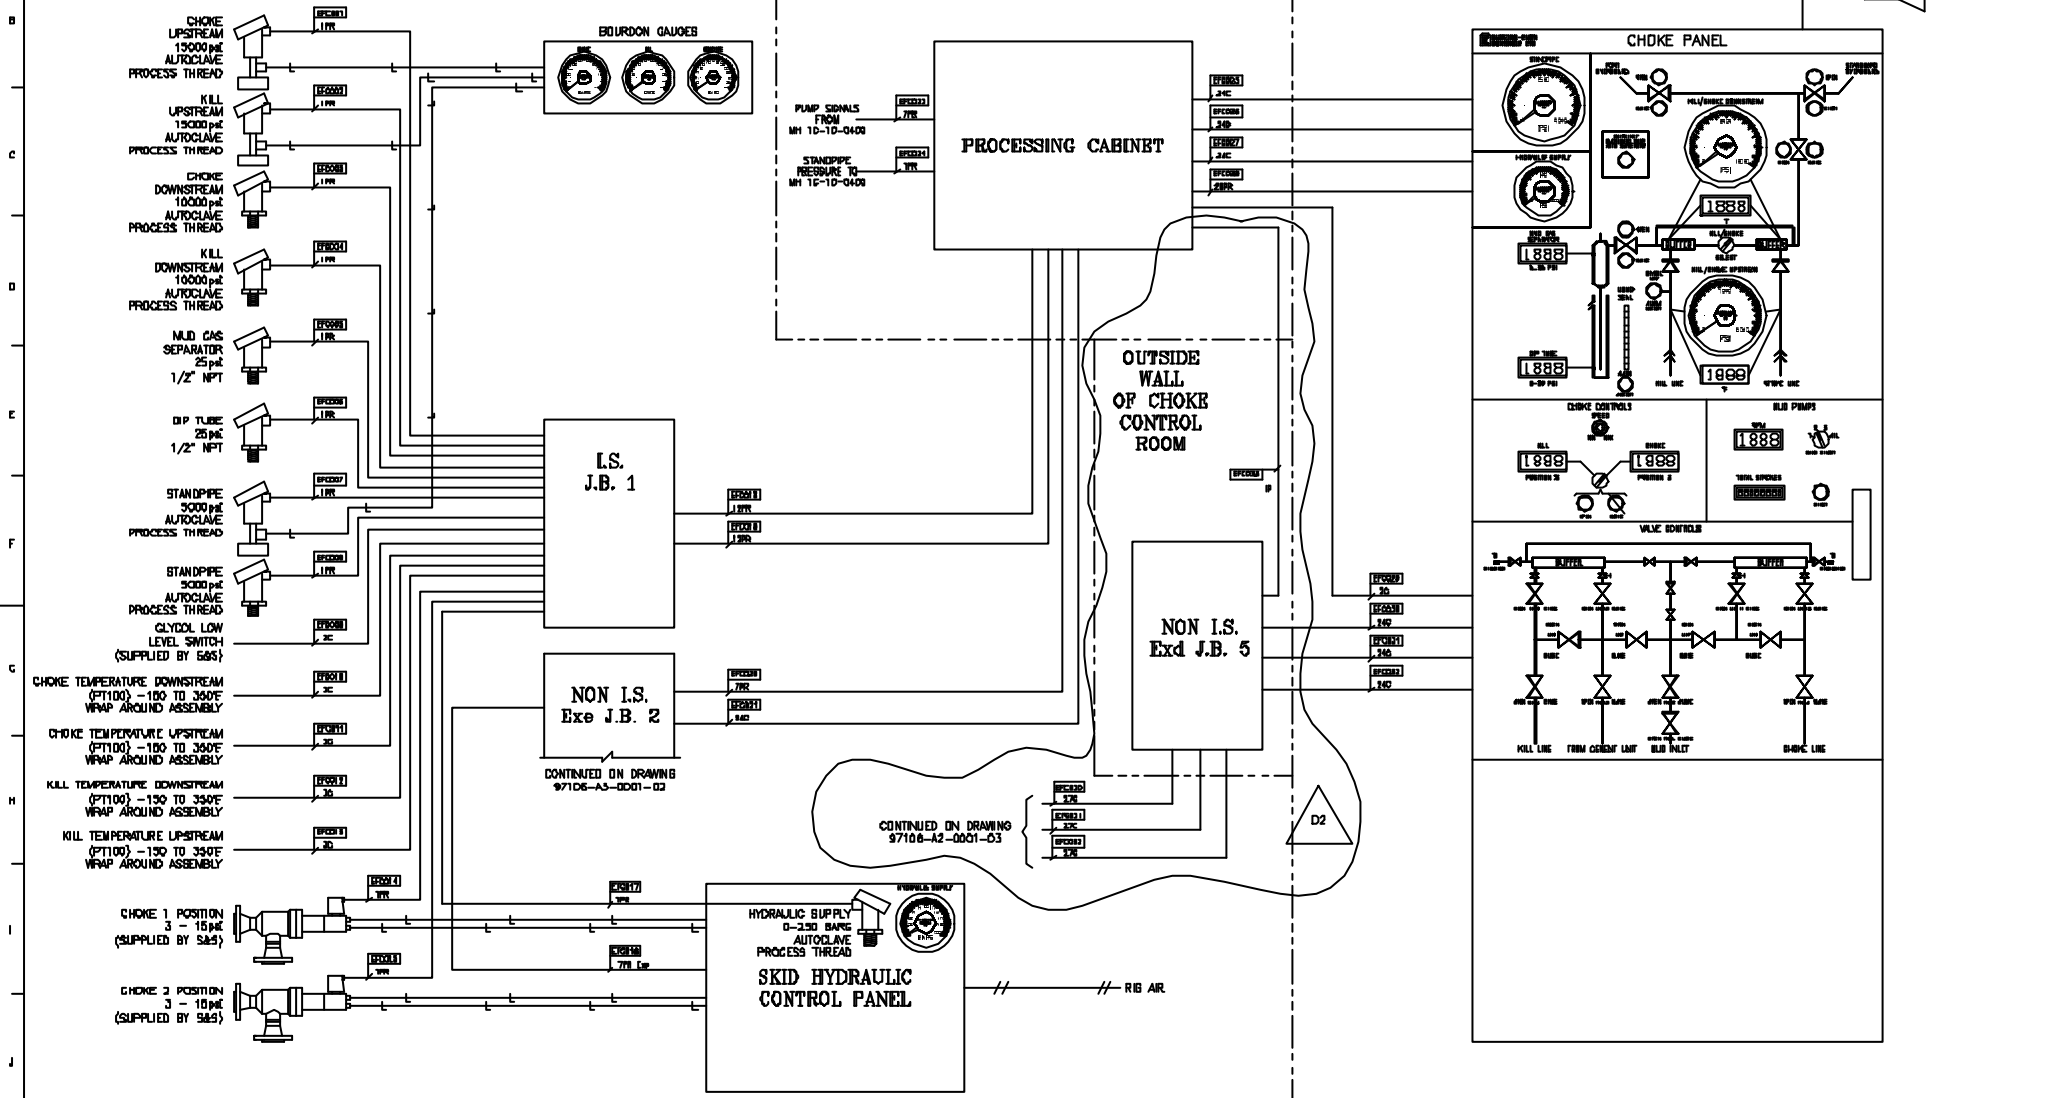

AS BUILT